REDISTRICTING 2011 - PLAN 10 - 8/17/2011
"Red"

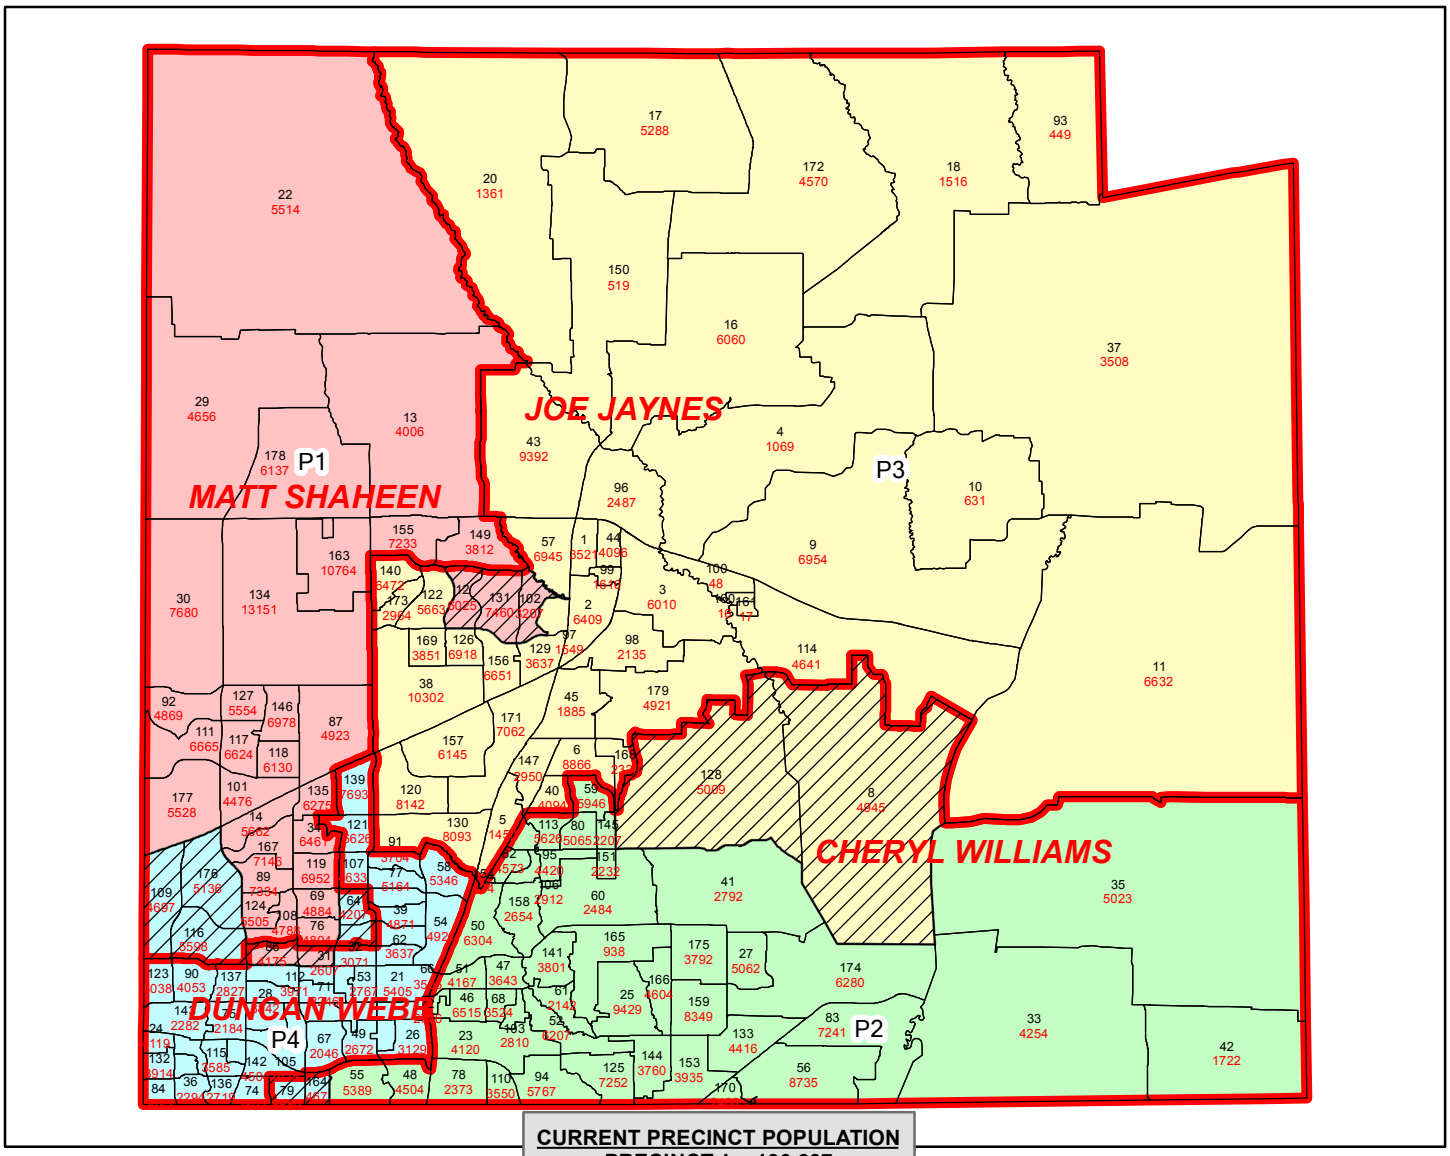

CURRENT PRECINCT POPULATION
PRECINCT 1 = 196,637
PRECINCT 2 = 213,742
PRECINCT 3 = 206,520
PRECINCT 4 = 165,442
(RED LINES ABOVE

TOTAL POPULATION: 782,341

OPTIMAL VALUE: 195,585

DIST_ID	Precinct	POP2010	POP2010_DEV	POP2010_DVP
1	P1	198075	2490	1.2731037656262
2	P2	196741	1156	0.591047370708388
3	P3	199782	4197	2.14587008206151
4	P4	187743	-7842	-4.00950993174323

PLAN 10

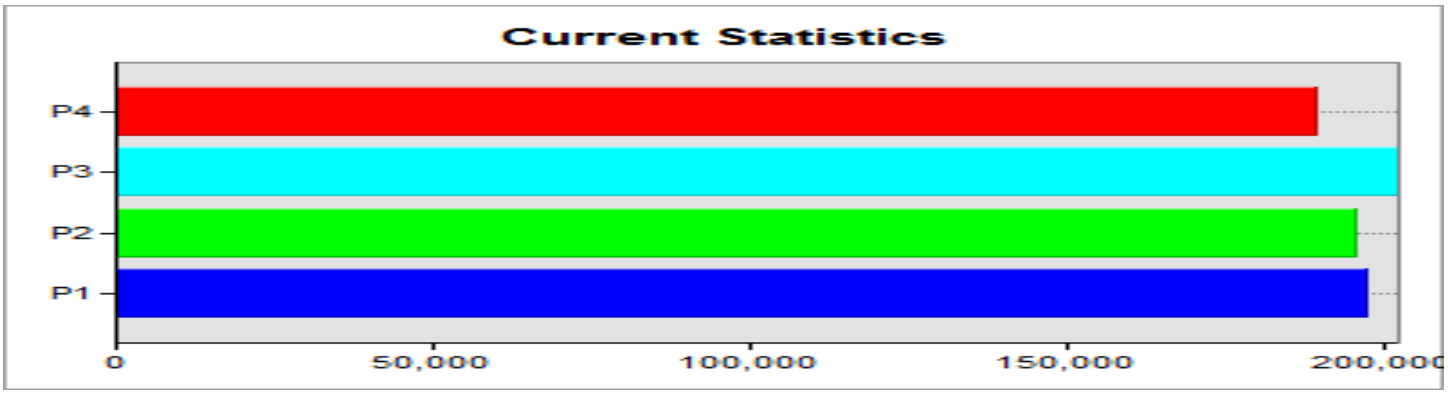

(New precincts are represented by different colors above. The hatching shows where they changed.) Collin County IT / GIS