

RESOLUTION NO. 2011-08-085 (R)

**A RESOLUTION OF THE CITY COUNCIL OF THE CITY OF MCKINNEY,
TEXAS SUPPORTING AN ALTERNATE REDISTRICTING PLAN FOR
COLLIN COUNTY, TEXAS; AND PROVIDING AN EFFECTIVE DATE.**

WHEREAS, the Mayor and City Council of the City of McKinney recognize the responsibilities of each governmental entity to fairly apportion elective districts and their included precincts under applicable federal and state laws, including but not limited to Amendments 14 and 15 to the United States Constitution, U.S.C.A. (West 2006) and the Voting Rights Act, 42 U.S.C.A. § 1973c (West 2010); and Tex. Gov't Code Ann. §§ 2058.001 and 2058.002 (Vernon 2008); and

WHEREAS, the Mayor and City Council have reviewed the Redistricting Plans proposed by the Commissioners' Court and interested citizens for the four (4) elective districts and their included precincts of Collin County, Texas; and

WHEREAS, after careful review, the Mayor and City Council desire to propose and support an alternate Redistricting Plan that more fairly and equitably preserves the rights and representative voting powers of the citizens of McKinney in electing county commissioners.

NOW, THEREFORE, BE IT RESOLVED BY THE CITY COUNCIL OF THE CITY OF MCKINNEY, TEXAS, THAT:

Section 1. The Redistricting Plan entitled "Alternative Option", attached hereto as Exhibit A, is hereby submitted to the Commissioners' Court as an alternative to the Redistricting Plan entitled "Red Map" attached hereto as Exhibit B.

Section 2. The City Council desires that the Commissioners' Court consider the "Alternative Option" or other alternative scenarios that more fairly and equitably preserve the rights and voting powers of the citizens of McKinney in electing County Commissioners as Collin County's final Redistricting Plan.

Section 3. This Resolution shall be effective immediately upon passage.


DULY PASSED AND APPROVED BY THE CITY COUNCIL OF THE CITY OF MCKINNEY, TEXAS ON THE 29th DAY OF AUGUST, 2011.

CITY OF MCKINNEY, TEXAS


BRIAN LOUGHMILLER
Mayor

ATTEST:


SANDY HART, TRMC, MMC
City Secretary
BLANCA I. GARCIA
Assistant City Secretary

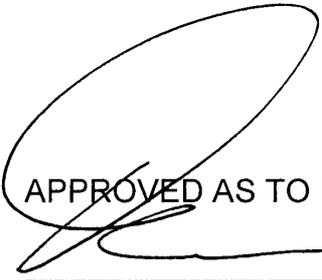


APPROVED AS TO FORM:

MARK S. HOUSER
City Attorney



EXHIBIT B

REDISTRICTING 2011 - PLAN 10 - 8/17/2011
"Red"

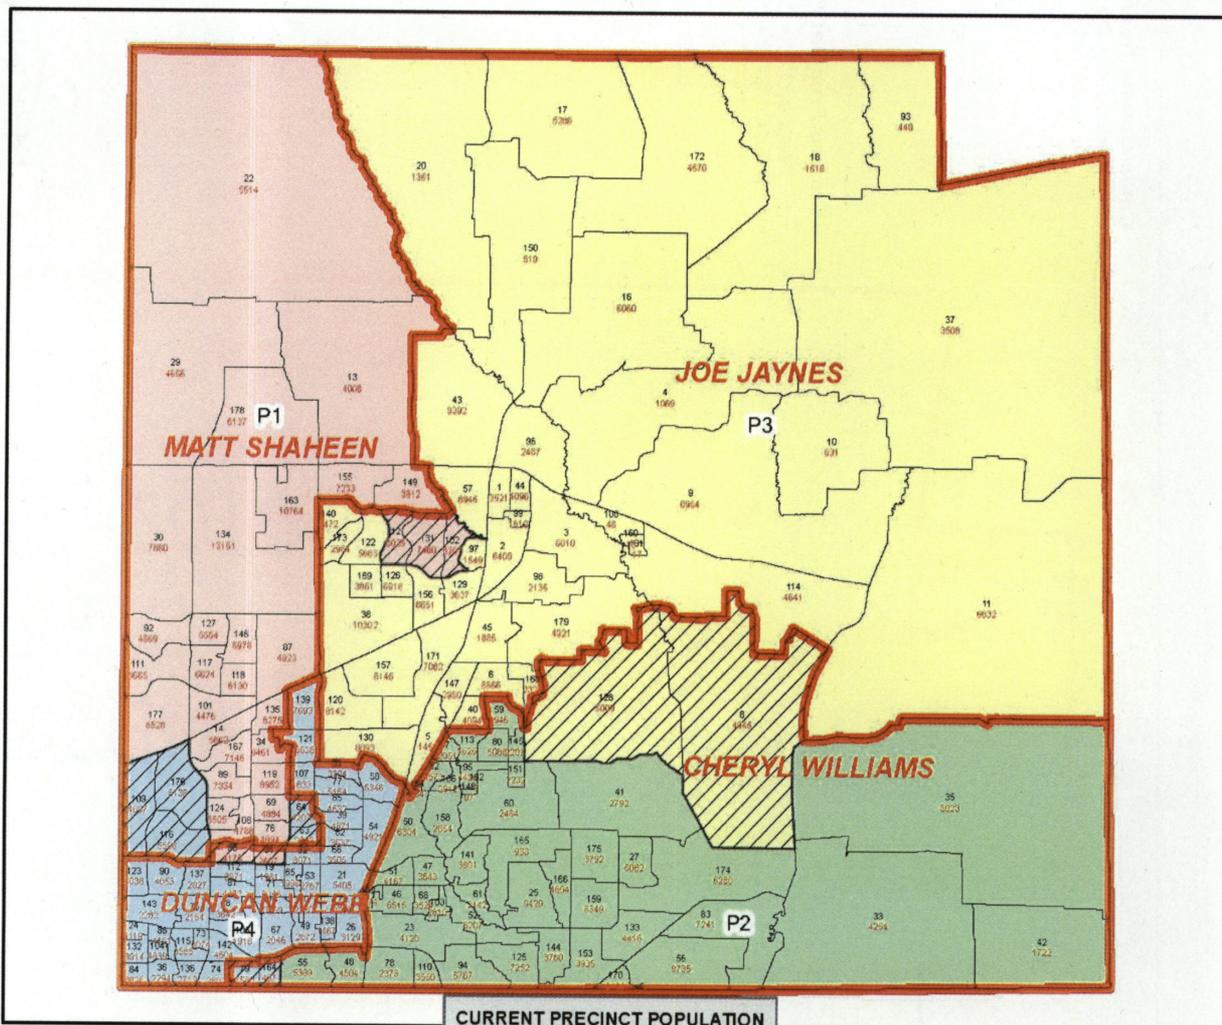


TOTAL POPULATION: 782,341

CURRENT PRECINCT POPULATION
 PRECINCT 1 = 196,637
 PRECINCT 2 = 213,742
 PRECINCT 3 = 206,520
 PRECINCT 4 = 165,442
 (RED LINES ABOVE)

OPTIMAL VALUE: 195,585

DIST_ID	Precinct	POP2010	POP2010_DEV	POP2010_DVP
1	P1	198075	2490	1.2731037656282
2	P2	196741	1156	0.591047370708388
3	P3	199782	4197	2.14587008206151
4	P4	187743	-7842	-4.00950993174323

PLAN 10

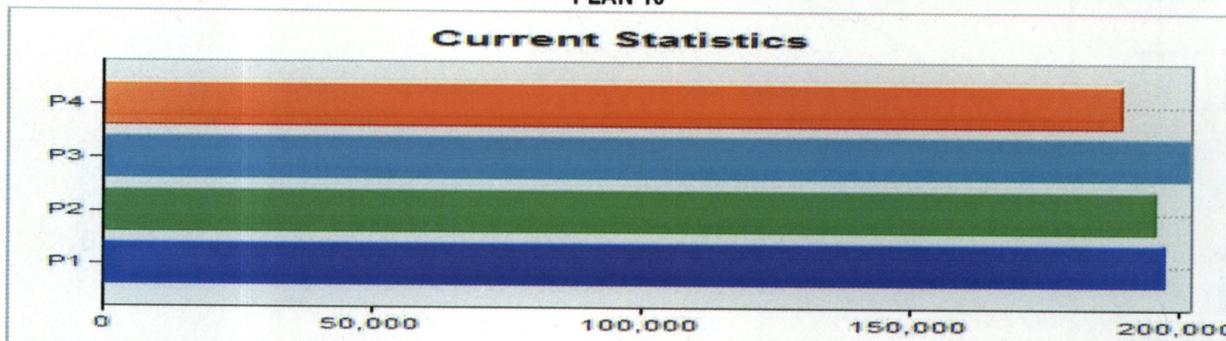

(New precincts are represented by different colors above. The hatching shows where they changed.) Collin County IT / GIS